


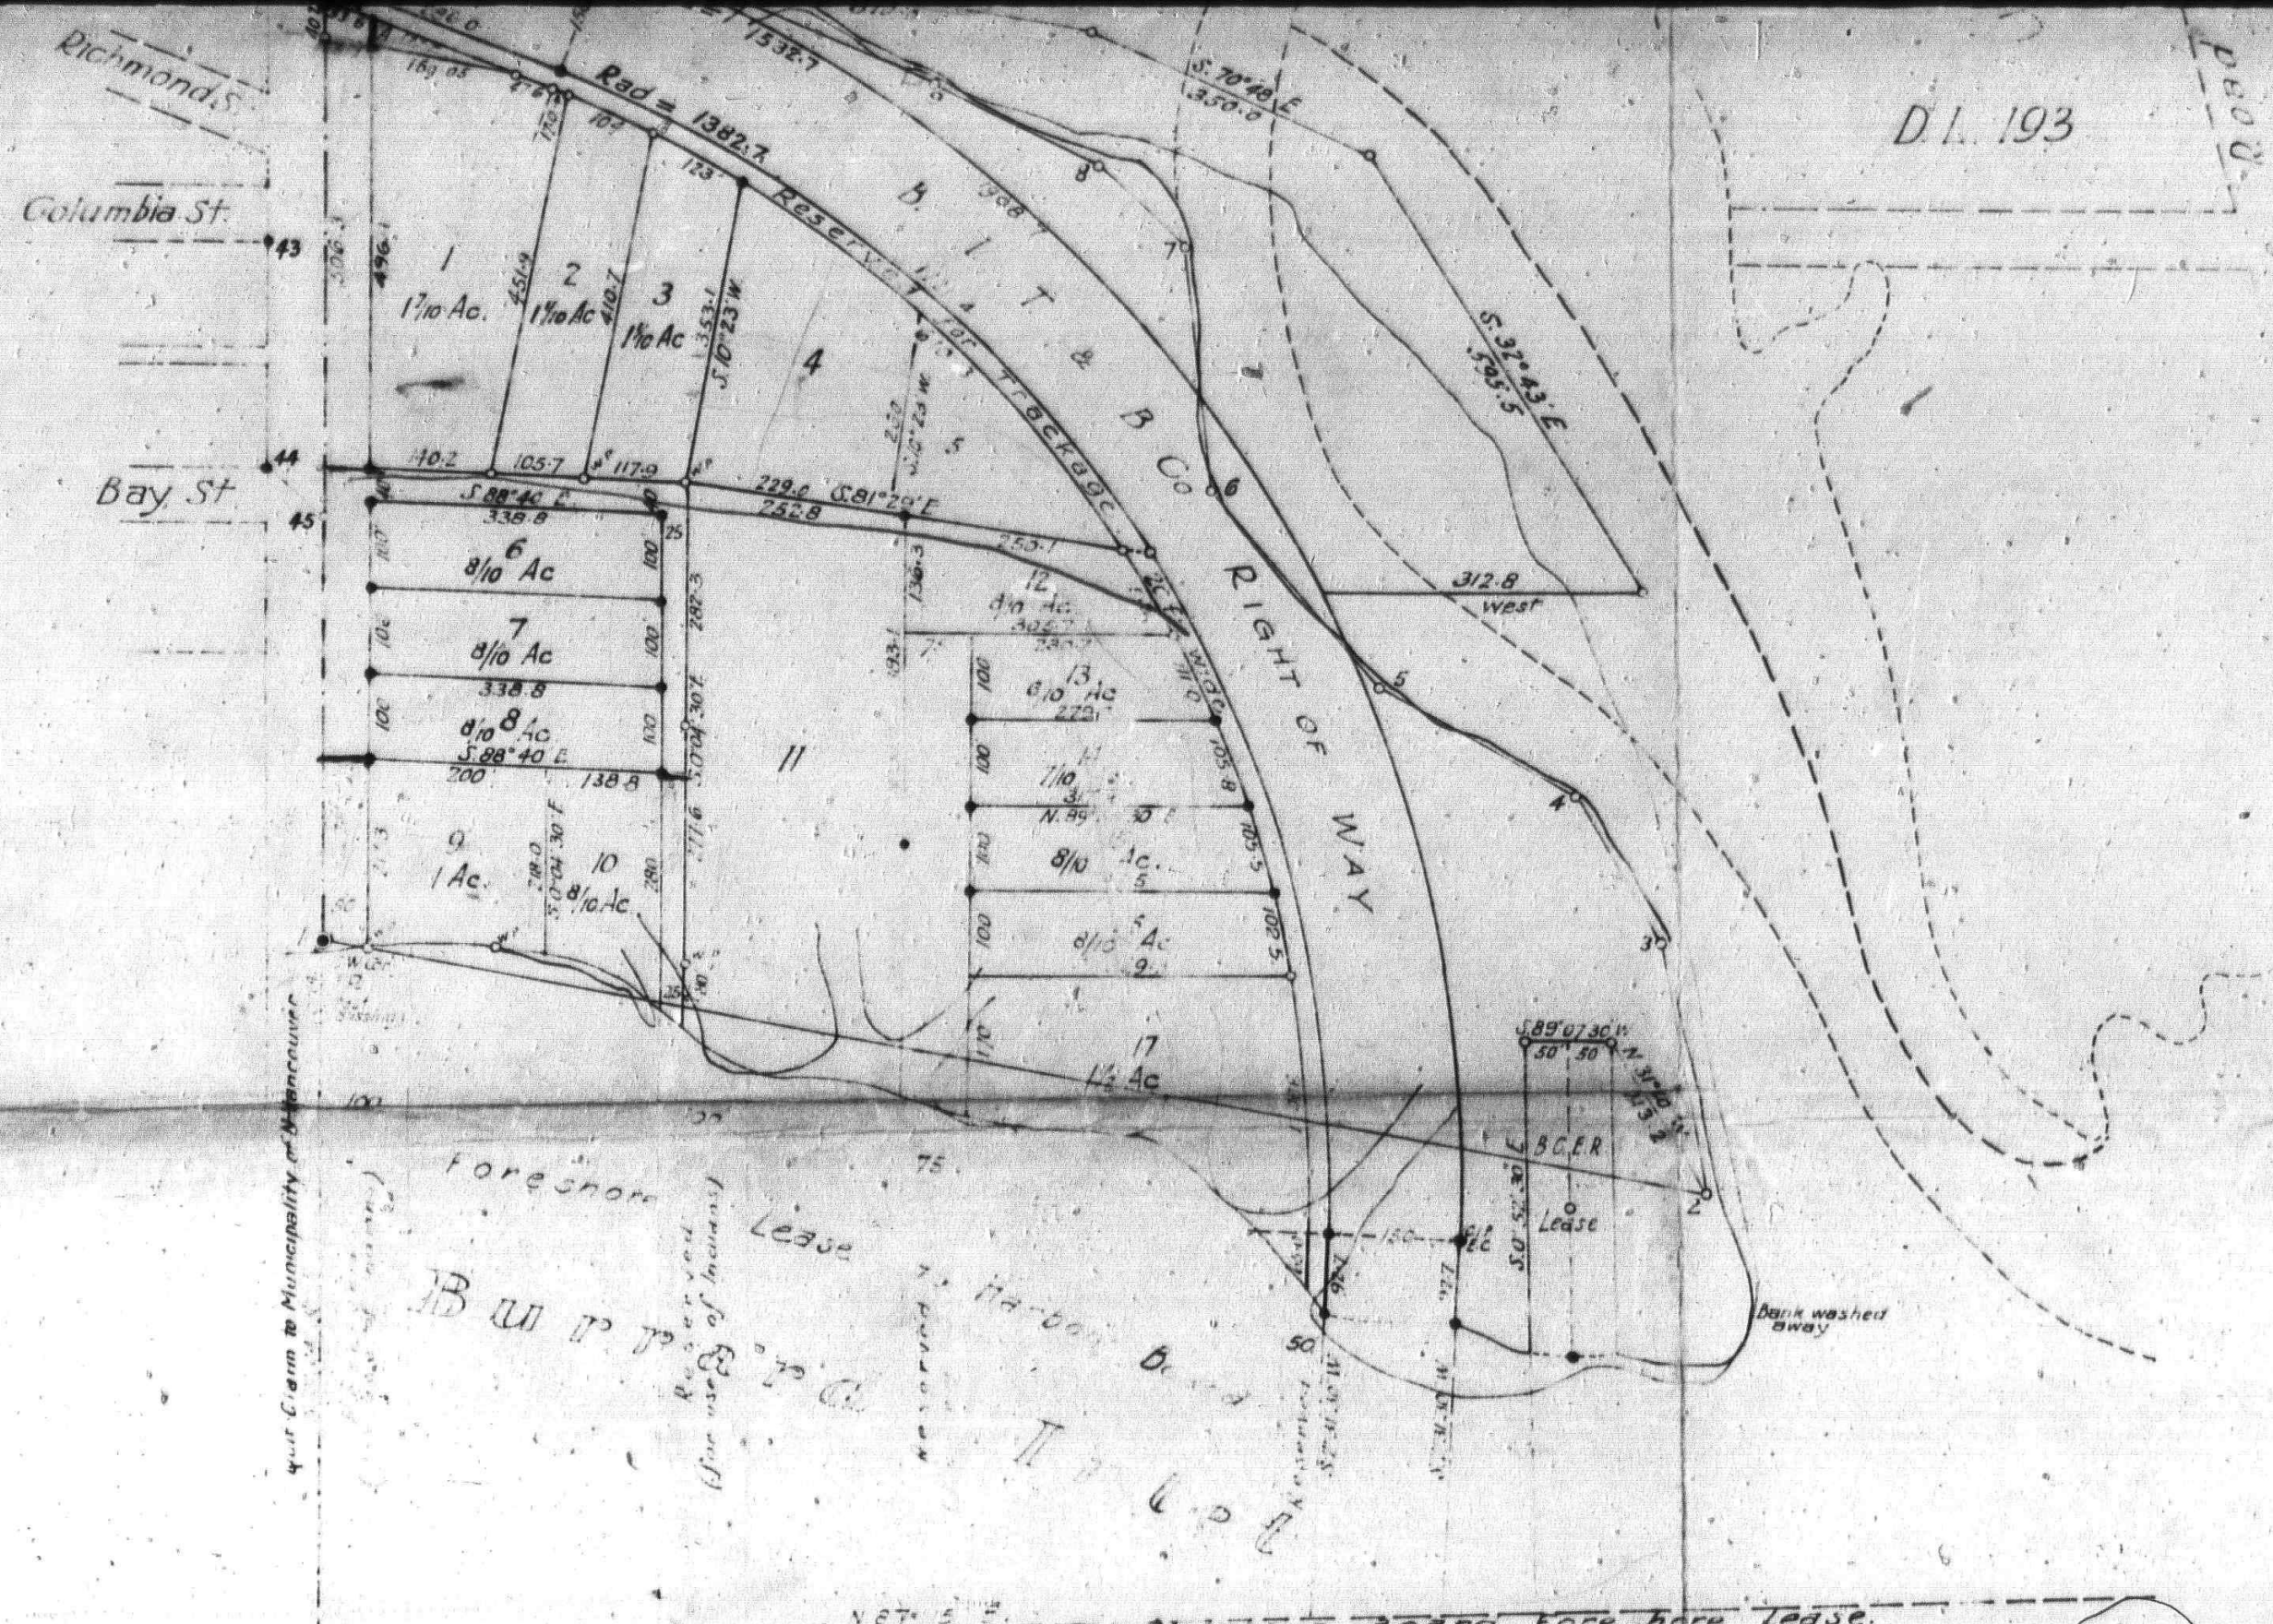

STATION	BEARING	DISTANCE
1-2	S. 74° 20' E.	1604.6
2-3	N. 9° 51' W.	300.0
3-4	N. 30° 05' W.	198.6
4-5	N. 60° 09' W.	259.5
5-6	N. 39° 57' W.	298.0
6-7	N. 5° 40' W.	286.9
7-8	N. 46° 24' W.	137.8
8-9	N. 62° 38' W.	210.5
9-10	N. 66° 14' W.	245.1
10-11	N. 57° 43' W.	228.9
11-12	N. 40° 52' W.	237.0
12-13	N. 8° 27' E.	150.6
13-14	N. 27° 08' W.	412.7
14-15	N. 8° 21' E.	194.0
15-16	N. 41° 13' E.	161.6
16-17	N. 59° 08' E.	157.5
17-18	N. 78° 28' E.	267.8
18-19	N. 89° 25' E.	443.5
19-20	N. 81° 36' E.	690.0
20-21	N. 89° 33' E.	540.4
21-22	N. 8° 28' E.	359.6
22-23	N. 44° 31' W.	242.5
23-24	S. 64° 17' W.	340.7
24-25	N. 54° 57' W.	183.4
25-26	N. 18° 46' W.	335.8
26-27	N. 21° 24' E.	314.8
27-28	N. 46° 10' E.	510.0
28-29	N. 62° 17' E.	326.8
29-30	N. 23° 07' E.	255.0
30-31	N. 12° 07' E.	157.2
31-32	N. 70° 47' W.	102.2
32-33	N. 89° 59' W.	56.7
33-34	S. 54° 31' W.	1012.5
34-35	N. 10° 13' W.	707.2
35-36	N. 46° 19' W.	559.3
36-37	N. 89° 53' W.	334.4
37-38	S. 0° 07' W.	1520.0
38-39	S. 17° 28' W.	192.9
39-40	S. 0° 12' W.	677.0
40-41	S. 0° 31' W.	351.1
41-42	S. 1° 09' W.	606.6
42-43	S. 1° 17' E.	389.9
43-44	S. 0° 02' E.	264.1
44-45	S. 48° 28' E.	88.4
45-1	S. 0° 02' E.	491.0

Legend
 Brown Lines denote Capt. Jewett's B.C.L.S. Survey 1880.
 Red Lines denote Traverse.
 Black Lines denote Survey 1926.
 Monuments thus ●
 Iron Posts thus ○
 Wood Posts thus ○
 Bearing Bdy Seymour Ave. from Reg. Map 1340.
 Area 1880 1470 Acres
 Area 1926 128.1

I, J. J. Burnes, of the City of North Vancouver, do hereby certify that I was present and personally superintend the survey represented on this plan and that the survey and plan are correct.
 This survey was completed the 24th day of February, 1926.
 Sworn before me at Vancouver this 26th day of March, 1926.

William Burnes
 A Notary Public in and for the Province of British Columbia

John Burnes
 B.C.L.S.